


# CERTIFIED DRAWING

COMP. : CPR27067  
 COND. : Contact Factory  
 COND. FAN : BLW27018  
 EVAP : HEX27284  
 SUC.ACC : HEX27001  
 PUMP : E-PMP27354

ALL DIMENSIONS ARE IN INCHES UNLESS OTHERWISE SPECIFIED.

DRAWN BY	ANG	DATE	18/12/2015
APPROVED BY	CS	DATE	18/12/2015

REV	DESCRIPTION	DATE	REV BY	APP BY
03.	AS BUILT	04.04.16	JUN HO	CS TAN
02.	REVISED PANEL LAYOUT	02.03.16	HO ANG	CS TAN
01.	UNIT LENGTH WAS 125"	05.02.16	ANG	CS TAN

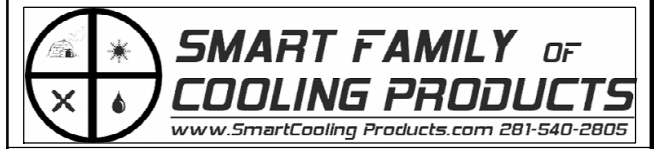

PROJECT RENTAL SCROLL CHILLER  
 F/O :

MODEL SCOD 35 AR4

TITLE  
 18096-AIR COOLED SCROLL DX RENTAL CHILLER

DRAWING NO S110550281

A4 SCALE : N.T.S SHEET OF

